


SCHIEVLING PLANTATION
 EXT.1787-888 JOB#00200007
 PHASE II


NO. 4131
 GRID 539

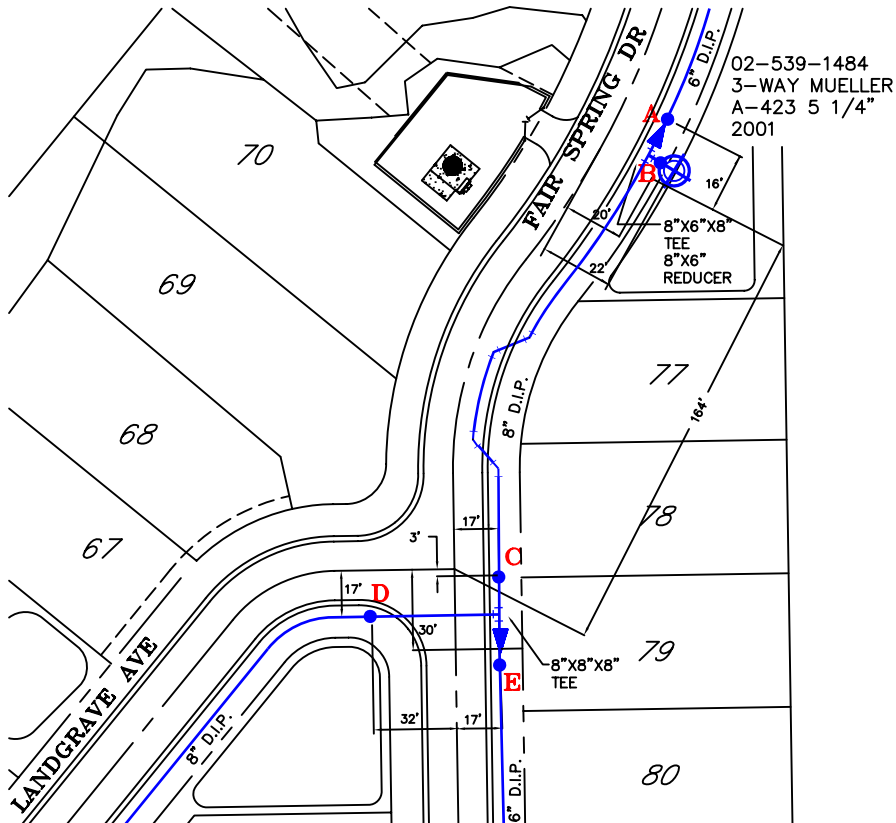

TYPICAL VALVE CARD

NOTE: THE NUMBER OF TURNS FOR VALVES SHALL BE FIELD DETERMINED AND NOT TAKEN FROM MANUFACTURER'S MANUAL.

LOCATION	SIZE	MAKE	DATE SET	NO.TURNS
A	6"	MUELLER GATE	11/10/01	21
B	6"	MUELLER GATE	11/10/01	21
C	8"	MUELLER GATE	11/10/01	27
D	8"	MUELLER GATE	11/10/01	27
E	6"	MUELLER GATE	11/10/01	21

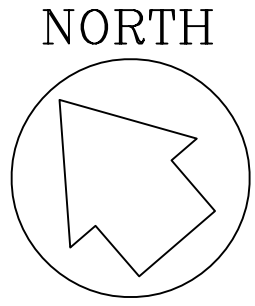

REVISD BY: _____ DRAWN BY: WB/BH
 DATE: 6/6/02 _____ CHECKED BY: _____

CHARLESTON WATER SYSTEM		
TYPICAL VALVE CARD		
APPROVED BY: CWS	DATE: MAR 2000	DRAWING NO. 28
SCALE: NTS	REVISED: FEB 2010	